

ROLL NUMBER						
000-000-000						
LEGAL DESCRIPTION						
LOT	BKL	D.L.	RGE	SEC	PLAN	DISTRICT
LOT 5	##	D.L #	##	##	EPP###	OYSTER




TOWN OF LADYSMITH
SERVICE CARD

ADDRESS OF PROPERTY

123 SOMEWHERE
BOULVDARD

	WATER	SANITARY SEWER	STORM DRAIN	COMMENTS:
Meter ID Number	c123456			
Meter Type & Size	sensus			
Installation Date	jan 2200	Jan 2200	Jan 2200	
Service Size	00mm	00mm	00mm	
Location at P.L.	00 EofN PL	00 E of N	00 E of N	
Invert at P.L.	00m	00 m	00 m	
Length of Connection	00	00m	00m	
Depth at Main	00m	00m	00m	
Type of Pipe	PE	PVC	PVC	
Dist. From Wye to MH		00m	00m	
Measured from MH No.		MH 00	MH 00	

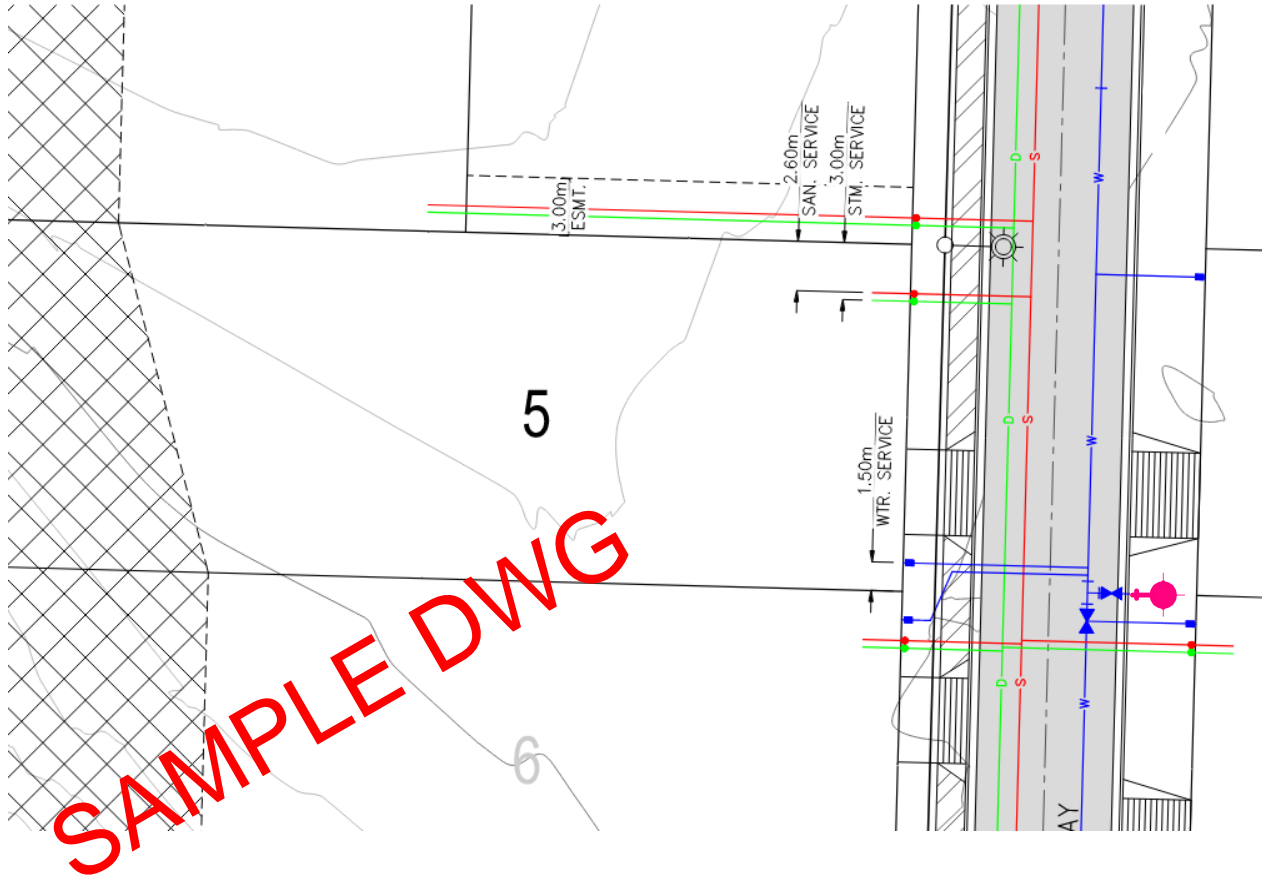

SANITARY SYSTEM		WATER SYSTEM		SCALE: 1:250	
<ul style="list-style-type: none"> — s — MAIN — SERVICE PIPE — FM — FORCE MAIN ● MANHOLE ⊢ END CAP ○ CLEANOUT 	<ul style="list-style-type: none"> — v — MAIN — SERVICE PIPE ⋈ VALVE ● MANHOLE ⊢ CAPPED END ⊠ WATER METER ◆ FIRE HYDRANT NEW ◆ FIRE HYDRANT 	<ul style="list-style-type: none"> — d — MAIN — SERVICE PIPE — P — PERFORATED ● MANHOLE ○ CLEANOUT — SWALE/DITCH — CONC. HEADWALL ■ CATCH BASIN ⊢ END CAP 	<p>INFORMATION SHOWN ON THIS DRAWING IS COMPILED FROM NUMEROUS SOURCES AND MAY NOT BE COMPLETE OR ACCURATE. THE TOWN OF LADYSMITH IS NOT RESPONSIBLE FOR ANY ERRORS, OMISSIONS OR DEFICIENCIES IN THESE DRAWINGS.</p> <p>CONFIRM UNDERGROUND LOCATION OF UTILITIES WITH UTILITY COMPANIES.</p>		